

Tricia Thigpen

From: Samantha Abell <sabell@gautier-ms.gov>
Sent: Thursday, January 31, 2013 10:53 AM
To: tthigpen@gautier-ms.gov
Subject: FW: Bayou View Circle Drainage Easement
Attachments: Bayou View Circle Easement Sketch.pdf; Right of Entry.doc

Tricia,
Per Bob Ramsay please add to agenda, along with this email from Chad.

TY

From: Chad Jordan [<mailto:chad.jordan@clearwatersol.com>]
Sent: Thursday, January 31, 2013 8:22 AM
To: sabell@gautier-ms.gov
Cc: adamcolledge@aol.com
Subject: RE: Bayou View Circle Drainage Easement

Sam,
As we discussed on Monday, the owner is not willing to execute a permanent easement. I will have the attached sketch revised to show as a temporary easement. Also, please find attached a Right of entry form I intend to have the owner sign giving us permission to enter private property and perform work. Let me know if we need council / legal approval before presenting to the owner or if you have any recommendations. Thanks.

Chad N. Jordan, PE
Project Manager
ClearWater Solutions, LLC
3305 Gautier Vancleave Rd.
Gautier, Ms 39553
Cell Phone 251-209-6292
www.clearwatersol.com

From: Chad Jordan [<mailto:chad.jordan@clearwatersol.com>]
Sent: Thursday, January 17, 2013 1:04 PM
To: sabell@gautier-ms.gov
Cc: adamcolledge@aol.com
Subject: FW: Bayou View Circle Drainage Easement

Sam, please see attached and let me know if your legal counsel or anyone else needs to review before executing. The property owner has agreed to sign whatever documents required in order to get the drainage problem fixed. Let me know if any questions. Thanks.

Chad N. Jordan, PE
Project Manager
ClearWater Solutions, LLC
3305 Gautier Vancleave Rd.
Gautier, Ms 39553
Cell Phone 251-209-6292
www.clearwatersol.com

From: Kirk Clayton [<mailto:kclayton@gmcnetwork.com>]
Sent: Thursday, January 17, 2013 11:06 AM
To: Chad Jordan (chad.jordan@clearwatersol.com)
Subject: Bayou View Circle Drainage Easement

Chad,

Attached are the documents we have been discussing for the referenced project. Please don't hesitate to contact me if you have any questions.

Thanks,
Kirk Clayton PLS
Surveying

Tel	251.964.8866
Fax	251.964.8869
Cell	251.370.0630

Kirk.Clayton@gmcnetwork.com
2127 North HickorySt.
Suite F
Loxley, AL 36551

GOODWYN | MILLS | CAWOOD
GMCNETWORK.COM

This email and any attached files are confidential and intended solely for the intended recipient(s). If you are not the named recipient you should not read, distribute, copy or alter this email. Any views or opinions expressed in this email are those of the author and do not represent those of the company. Warning: Although precautions have been taken to make sure no viruses are present in this email, the company cannot accept responsibility for any loss or damage that arise from the use of this email or attachments.

TEMPORARY RIGHT OF ENTRY

TO ENTER AND PERFORM WORK ON PRIVATE PROPERTY

I _____, do hereby attest to be the owner of the property

located at _____, and give ClearWater Solutions, LLC, agent for the City of Gautier, permission to enter said property and perform work necessary to repair/replace infrastructure on said property in accordance with the attached sketch.

Attest: _____
ClearWater Solutions, LLC


Date: _____

Attest: _____
Property Owner

Date: _____

HICKORY HILL ESTATES
UNIT NO. 7
PLAT BOOK 11, PAGE 23

SCALE
1" = 30'

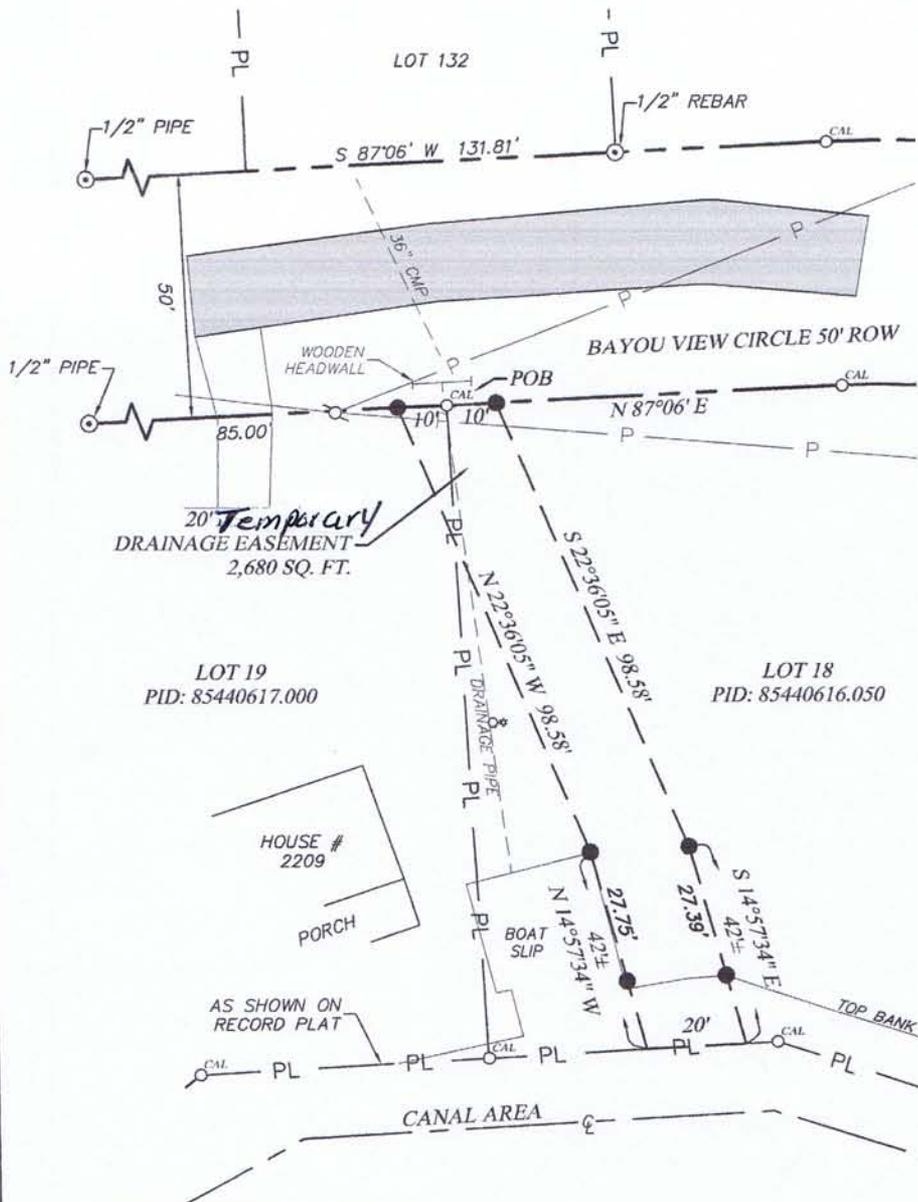

J:\CMOBI\30001 Gaultier General Services\Bayou View Circle.dwg January 17, 2013 Plotted By: kclayton

SYMBOL LEGEND	
○	LIGHT POLE / POWER POLE
●	5/8" REBAR (GMC GAP)
⊙	PROPERTY CORNER AS NOTED
PID	PARCEL IDENTIFICATION NUMBER
⊕	CENTERLINE
— PL —	PROPERTY LINE
— ROW —	RIGHT-OF-WAY
—	ASPHALT PAVEMENT/IMPROVED ROADWAY
○ CAL	CALCULATED POINT
● POB	POINT OF BEGINNING
— CMP —	CORRUGATED METAL PIPE

GENERAL NOTES:
1. PURPOSE OF THIS SKETCH IS TO ACCOMPANY A LEGAL DESCRIPTION.

2. BASIS OF BEARINGS: N. ROW LINE OF BAYOU VIEW CIRCLE (S87°06'W) - HICKORY HILL EST UNIT 7

EASEMENT SKETCH
PARCEL NUMBER: 85440616.050 & 617.000
BRANDI ANN NELSON
2209 Bayou View Cir, Gautier, MS 39553
GMC # CMOBI30001

SECTION: 12
TOWNSHIP: 7 SOUTH
RANGE: 7 WEST
COUNTY: JACKSON
SCALE: 1" = 30'
DATE: 01/10/2013
SHEET: 1 OF 1
HN

GOODWYN | MILLS | CAWOOD

2127 North Hickory Street, Suite F | Loxley, AL 36551
Tel 251.964.8866 | GMCNETWORK.COM